

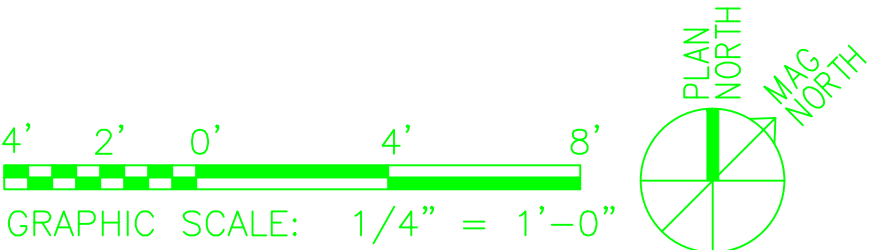
DEMOLITION BASEMENT LEVEL PLAN  
1/4" = 1'-0" EL. 813.83  
1  
- FA1.1





LEGEND

FACP	EXISTING FIRE ALARM CONTROL PANEL	DISP	NEW HSSD ALARM DISPLAY	L1	HSSD LEVEL 1 ALARM (ENCLOSURE)	RJ	RACEWAY JUNCTION BOX
SD	EXISTING SMOKE DETECTOR	WF	PRESSURE OPER WATERFLOW SWITCH	L2	HSSD LEVEL 2 ALARM (ENCLOSURE)	---	EXISTING FIRE ALARM CONDUIT
N SD	NEW SMOKE DETECTOR	VPS	VALVE POSITION SUPERVISORY SWITCH	B	NEW BELL/STROBE	---	NEW 3/4 INCH FIRE ALARM CONDUIT
HSSD	NEW HSSD DETECTOR	PS	SPRINKLER LOW AIR SUPERVISION	S	NEW STROBE	SO	HSSD SAMPLE ORIFACE
PWR	NEW POWER SUPPLY	EPO	EPO ABORT (ENCLOSURE)	B	EXISTING BELL	---	HSSD SAMPLE PIPE

KEYNOTES

① REMOVE EXISTING SMOKE DETECTORS, BELL, BOXES, AND RACEWAY.



<div><p><b>HYT Corporation</b> Fire Protection Engineers and Consultants 3498 Clayton Road - Suite 101 Concord, California 94519 Phone: (925) 681-2731 FAX: (925) 681-2733</p></div>		<div><p><b>TECTONICS</b> architects • planners • engineers 1500 PARK AVENUE EMERYVILLE, CA 94608-3551 TEL: (510) 740-2400</p></div>		<div><p>REGISTERED PROFESSIONAL ENGINEER BRETT B. TRESIDDER No. 1165 Exp. 9/30/08 FIRE PROTECTION STATE OF CALIFORNIA</p></div>		RECORD DRAWING AS-BUILT 28 SEPT 2012 AS PER CONTRACTOR'S MARK-UPS		ISSUED FOR CONSTRUCTION 05/27/2008		<table><tr><td></td><td></td><td></td><td></td><td></td><td></td><td></td><td></td><td></td><td></td></tr><tr><td></td><td></td><td></td><td></td><td></td><td></td><td></td><td></td><td></td><td></td></tr><tr><td></td><td></td><td></td><td></td><td></td><td></td><td></td><td></td><td></td><td></td></tr><tr><td></td><td></td><td></td><td></td><td></td><td></td><td></td><td></td><td></td><td></td></tr><tr><td></td><td></td><td></td><td></td><td></td><td></td><td></td><td></td><td></td><td></td></tr><tr><td></td><td></td><td></td><td></td><td></td><td></td><td></td><td></td><td></td><td></td></tr><tr><td>1</td><td>DWH</td><td>BBT</td><td>--</td><td>04/11/08</td><td>ENCLOSURE SIZE CHANGE</td><td colspan="4"></td></tr><tr><td>REVISION NUMBER</td><td>DRAWN BY</td><td>CHECKED BY</td><td>APPR'D BY</td><td>DATE</td><td>REMARKS</td><td colspan="4"></td></tr></table>																																																														1	DWH	BBT	--	04/11/08	ENCLOSURE SIZE CHANGE					REVISION NUMBER	DRAWN BY	CHECKED BY	APPR'D BY	DATE	REMARKS					<div><p>UNIVERSITY OF CALIFORNIA LAWRENCE BERKELEY NATIONAL LABORATORY <b>FACILITIES DIVISION</b></p></div>		<div><p>DRAWN BY DWH DATE 8/21/2007</p><p>CHECKED BY BBT 8/21/2007</p><p>CAD FILE PATH 00022608</p><p>SCALE As Noted</p></div>		<div><p>DRAWING NO. 4B72BE014 SHEET FA1.1</p><p>PROJECT NO. FM7200 OF</p></div>	
1	DWH	BBT	--	04/11/08	ENCLOSURE SIZE CHANGE																																																																																												
REVISION NUMBER	DRAWN BY	CHECKED BY	APPR'D BY	DATE	REMARKS																																																																																												